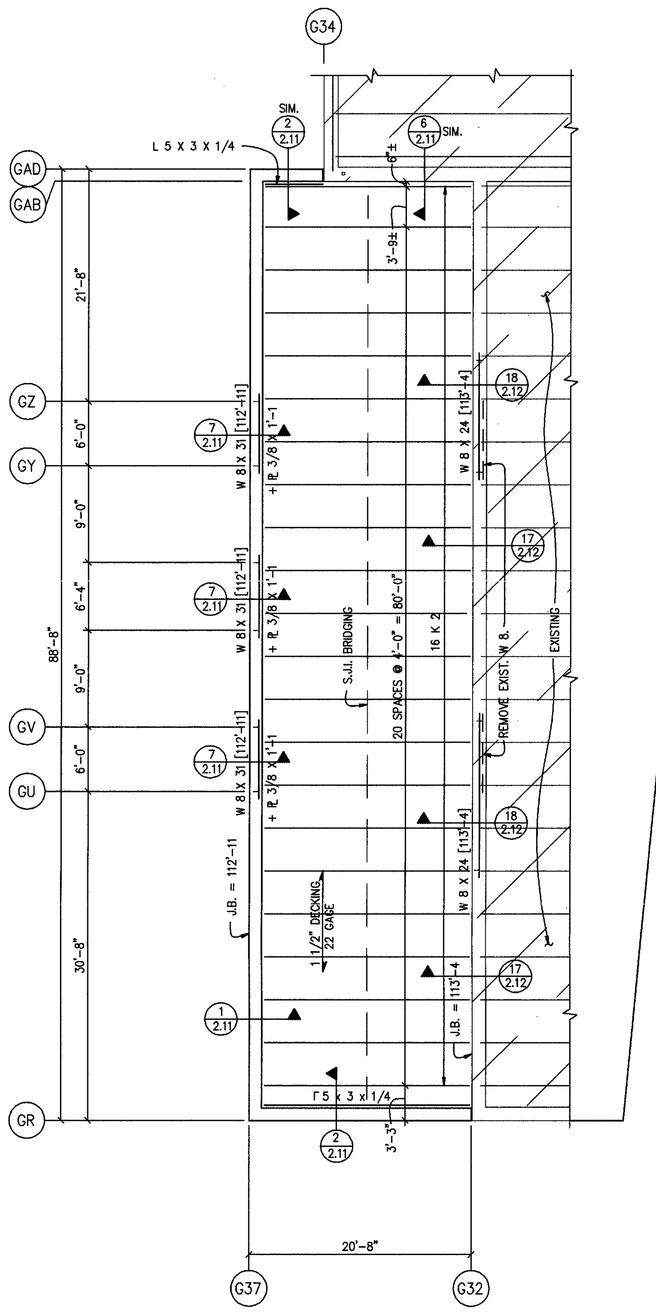

NOTE: TOP OF STEEL NOTED THUS [ ] ON PLAN.

ROOF FRAMING PLAN – AREA G

1/8" = 1'-0

N

ALTERNATE NO. 1

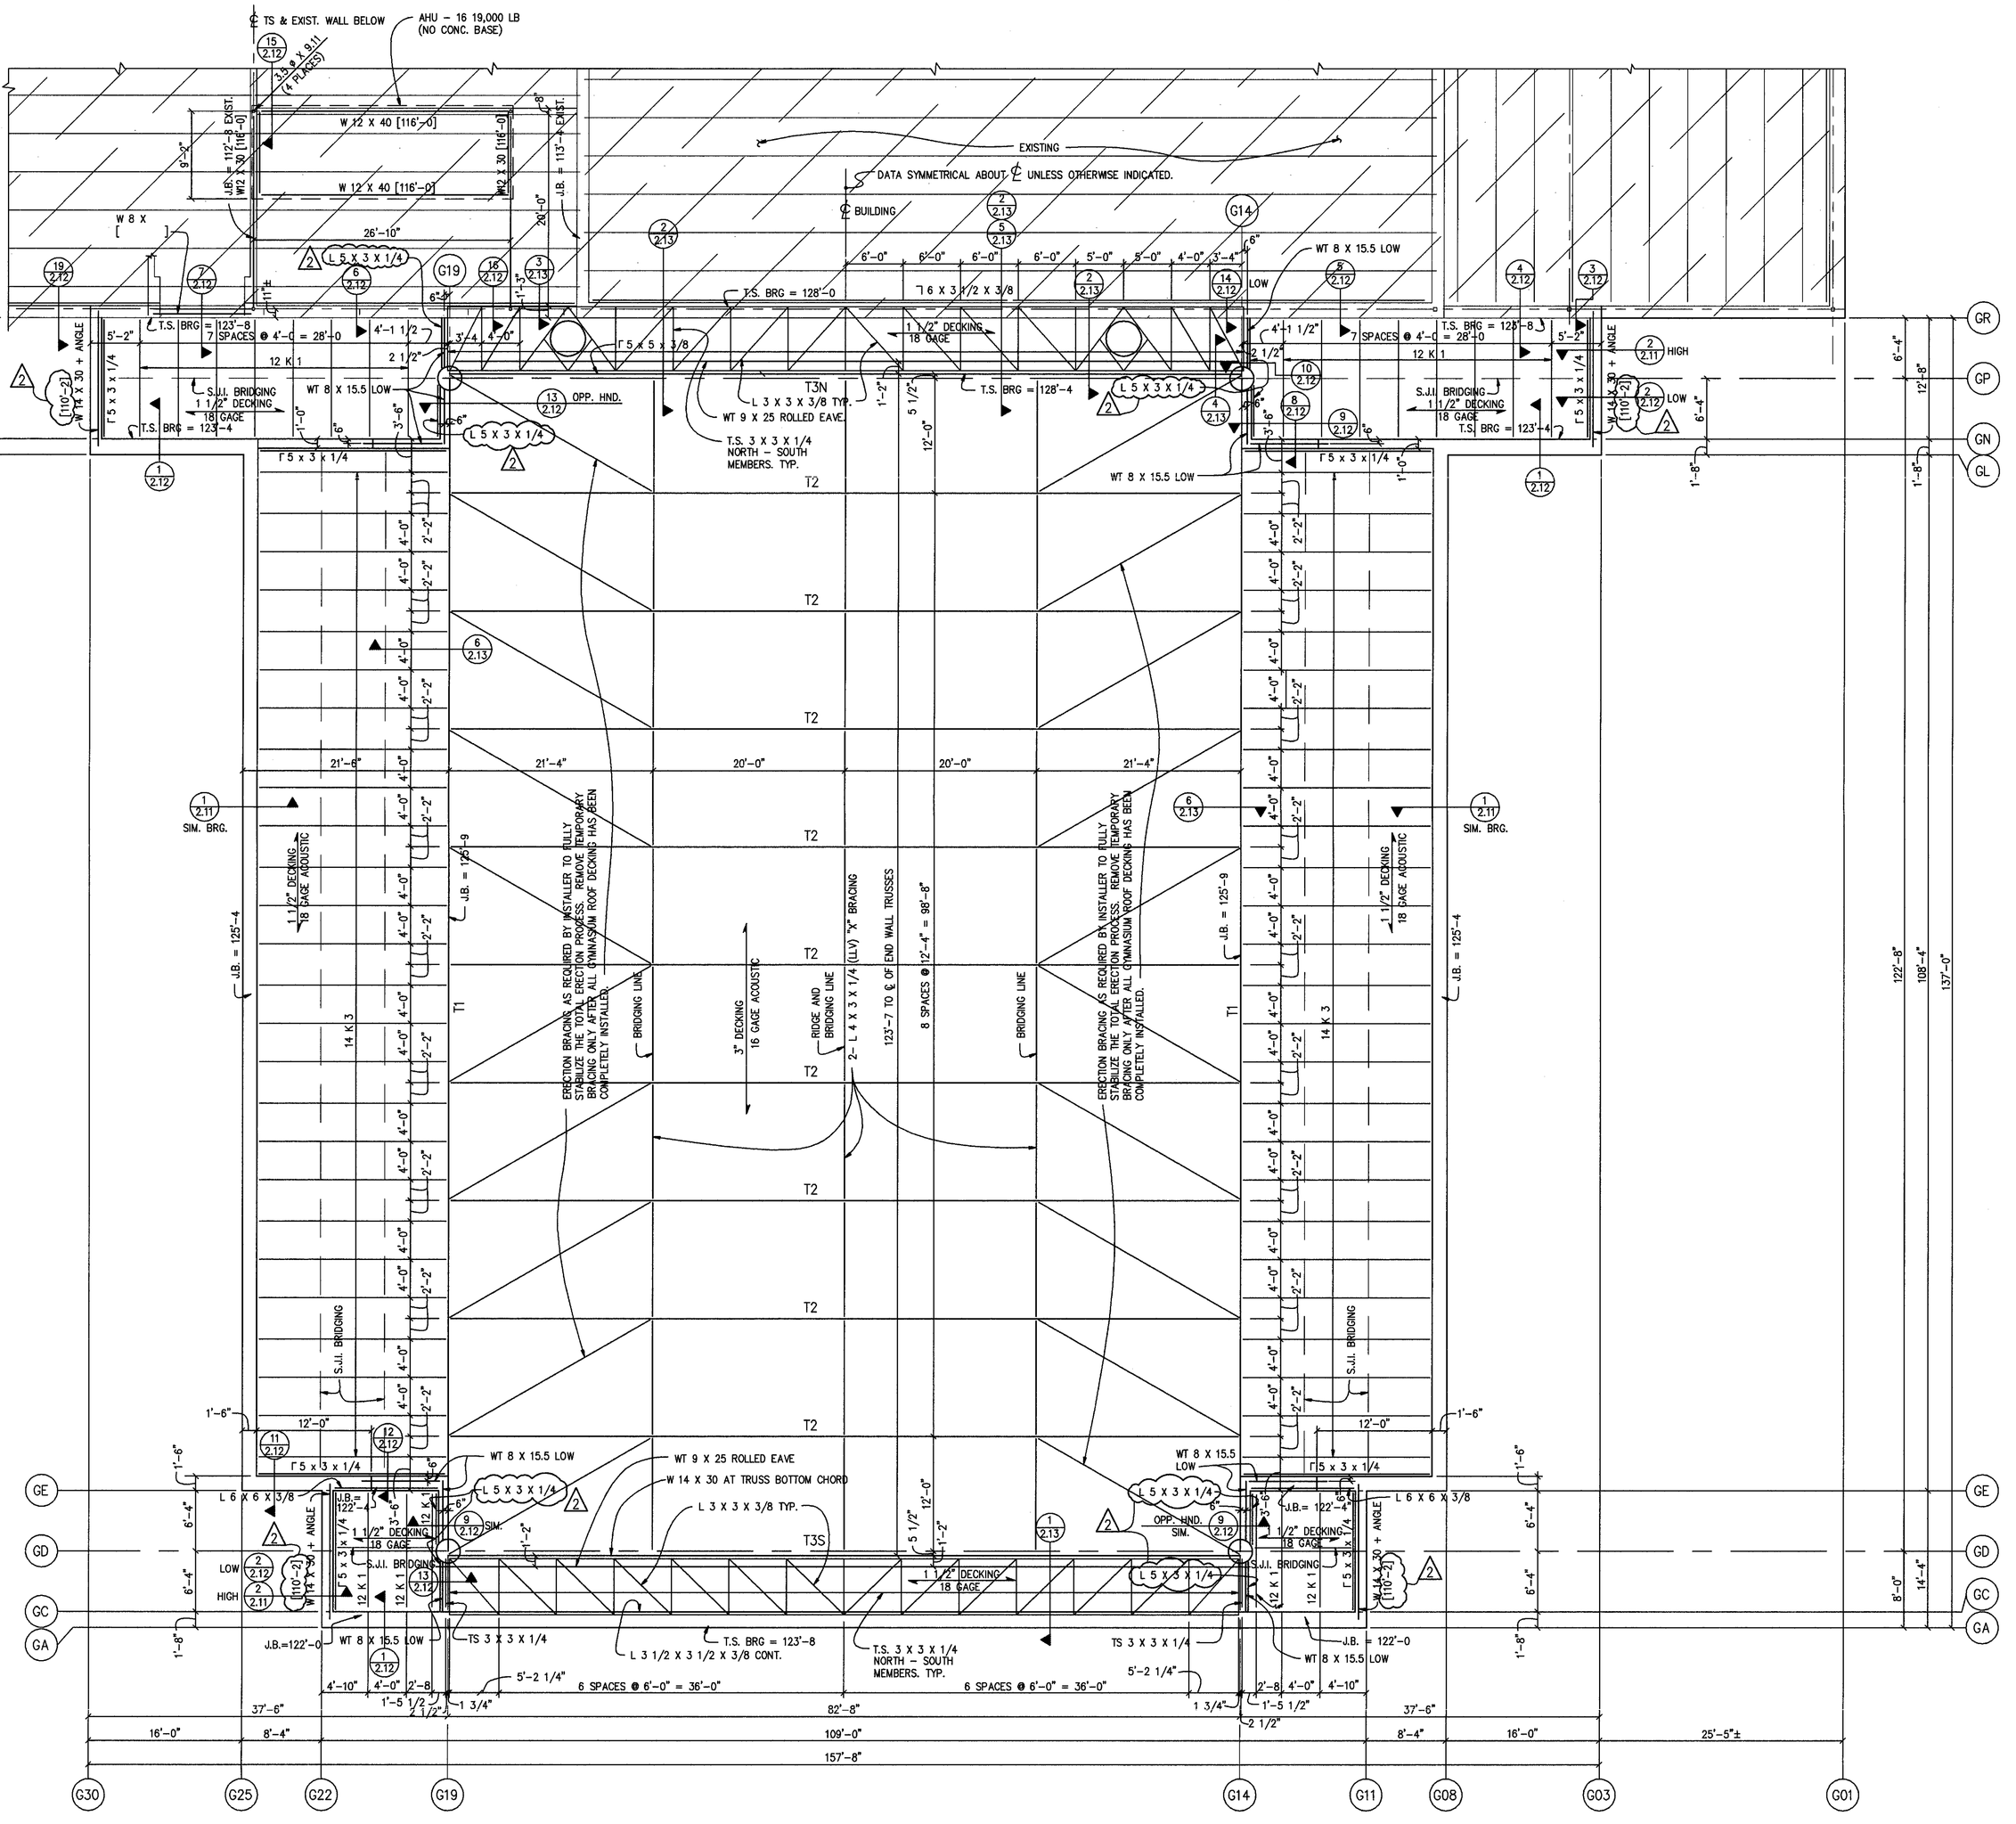

NOTE: TOP OF STEEL NOTED THUS [ ] ON PLAN.

ROOF FRAMING PLAN – AREA G

1/8" = 1'-0

N

SHEET NOTES

1. REFER TO THE GENERAL STRUCTURAL NOTES ON SHEET 2.1AB AND PROJECT SPECIFICATIONS FOR ADDITIONAL DATA.
2. 16 GAGE 3" ROOF DECK SHALL BE ATTACHED AT 6" ON CENTER AT END LAPS AND AT INTERMEDIATE SUPPORTS WITH 5/8" PUDDLE WELD. DECK SIDE LAPS WILL REQUIRE #10 SMS AT 12" MAX. O.C. INSTALLED FROM UNDER DECK.
3. 18 GAGE, 1 1/2" ROOF DECK SHALL BE ATTACHED AT 6" ON CENTER AT END LAPS AND AT INTERMEDIATE SUPPORTS WITH 5/8" PUDDLE WELD. FOR DECK SPANS EXCEEDING 12" SIDE LAPS WILL REQUIRE #10 SMS AT 12" MAX. O.C. INSTALLED FROM UNDER DECK.
4. 22 GAGE 1 1/2" ROOF DECK SHALL BE ATTACHED AS INDICATED IN THE SPECIFICATIONS.

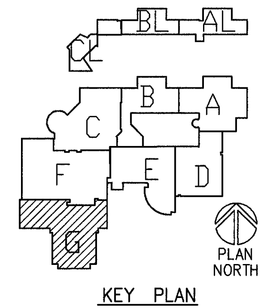

KEY PLAN

DATE	DESCRIPTION	BY	APPR'D
2/07/94	ISSUED FOR BID PACKAGE 4	RMM	RMM
3/29/94	⚠ COORDINATION AND CORRECTIONS	RMM	RMM
3/29/94	ISSUED FOR BID PACKAGE 5	RMM	RMM
6/25/96	Record Drawing		

RUSSELL M. MILLER
CONSULTING ENGINEERS
4000 Kern Street
Timnath, Colorado 80547
484-8376

P.N. 3193

POUDRE SCHOOL DISTRICT R-1

POUDRE HIGH SCHOOL

ADDITION & REMODEL

FORT COLLINS, COLORADO

Robb, Brenner, and Brelig, Inc.
125 S. Howes – Suite 880
Fort Collins, CO 80521

RB+B

JOB NUMBER
9222

DRAWN
CB / LS

CHECKED
RMM / ARG

ISSUE
03/29/94

REVISIONS

SHEET NAME
ROOF FRAMING PLAN AREA G

SHEET NUMBER
2.3G