IFB 21-401-002 Partnership Center Interior Renovation – Q&A Revised Drawing

Q5) The new ceiling plan has general note #10 pointing towards what appears to be a ceiling register. Note #10 references smoke seals on door jambs, can you please clarify?

A5) Reference Revised 3 Drawing 3/A1.0 below. Revise Keynote from Keynote 10 to Keynote 16.

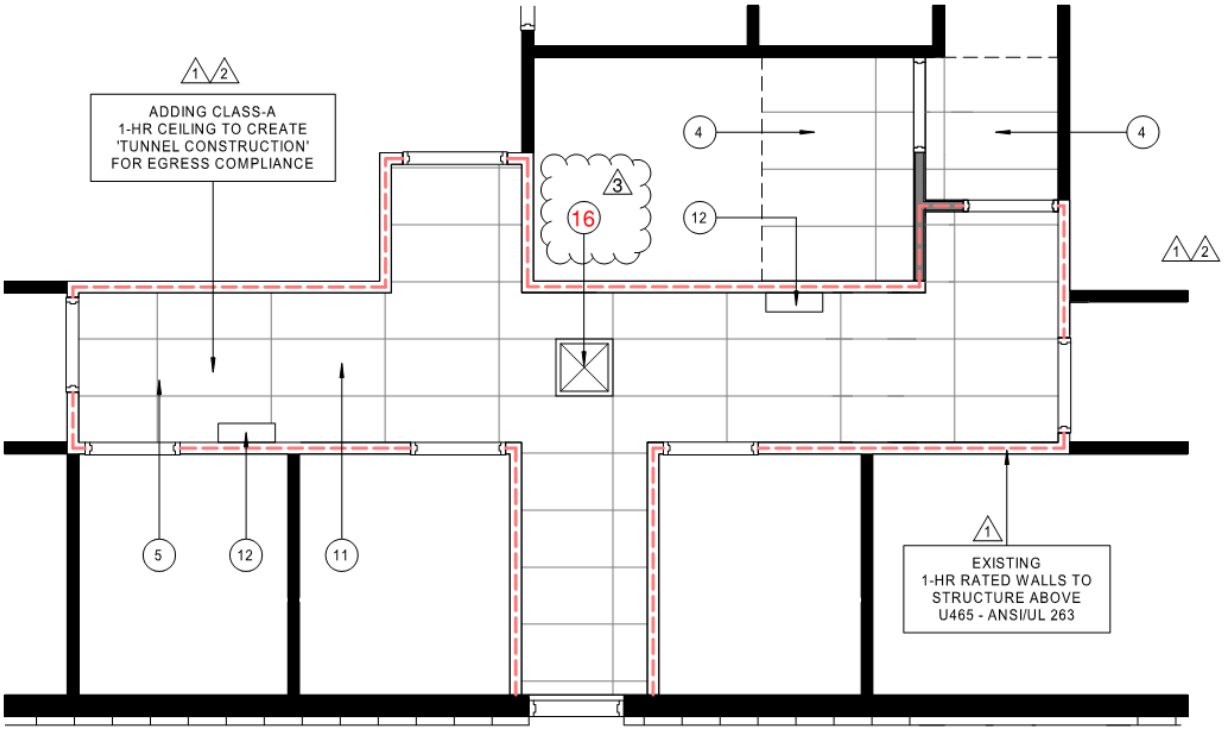

3 NEW CEILING PLAN
1/4" = 1'-0"

EXISTING 1-HR RATED WALLS: U465 - ANSI/UL 263 1

N