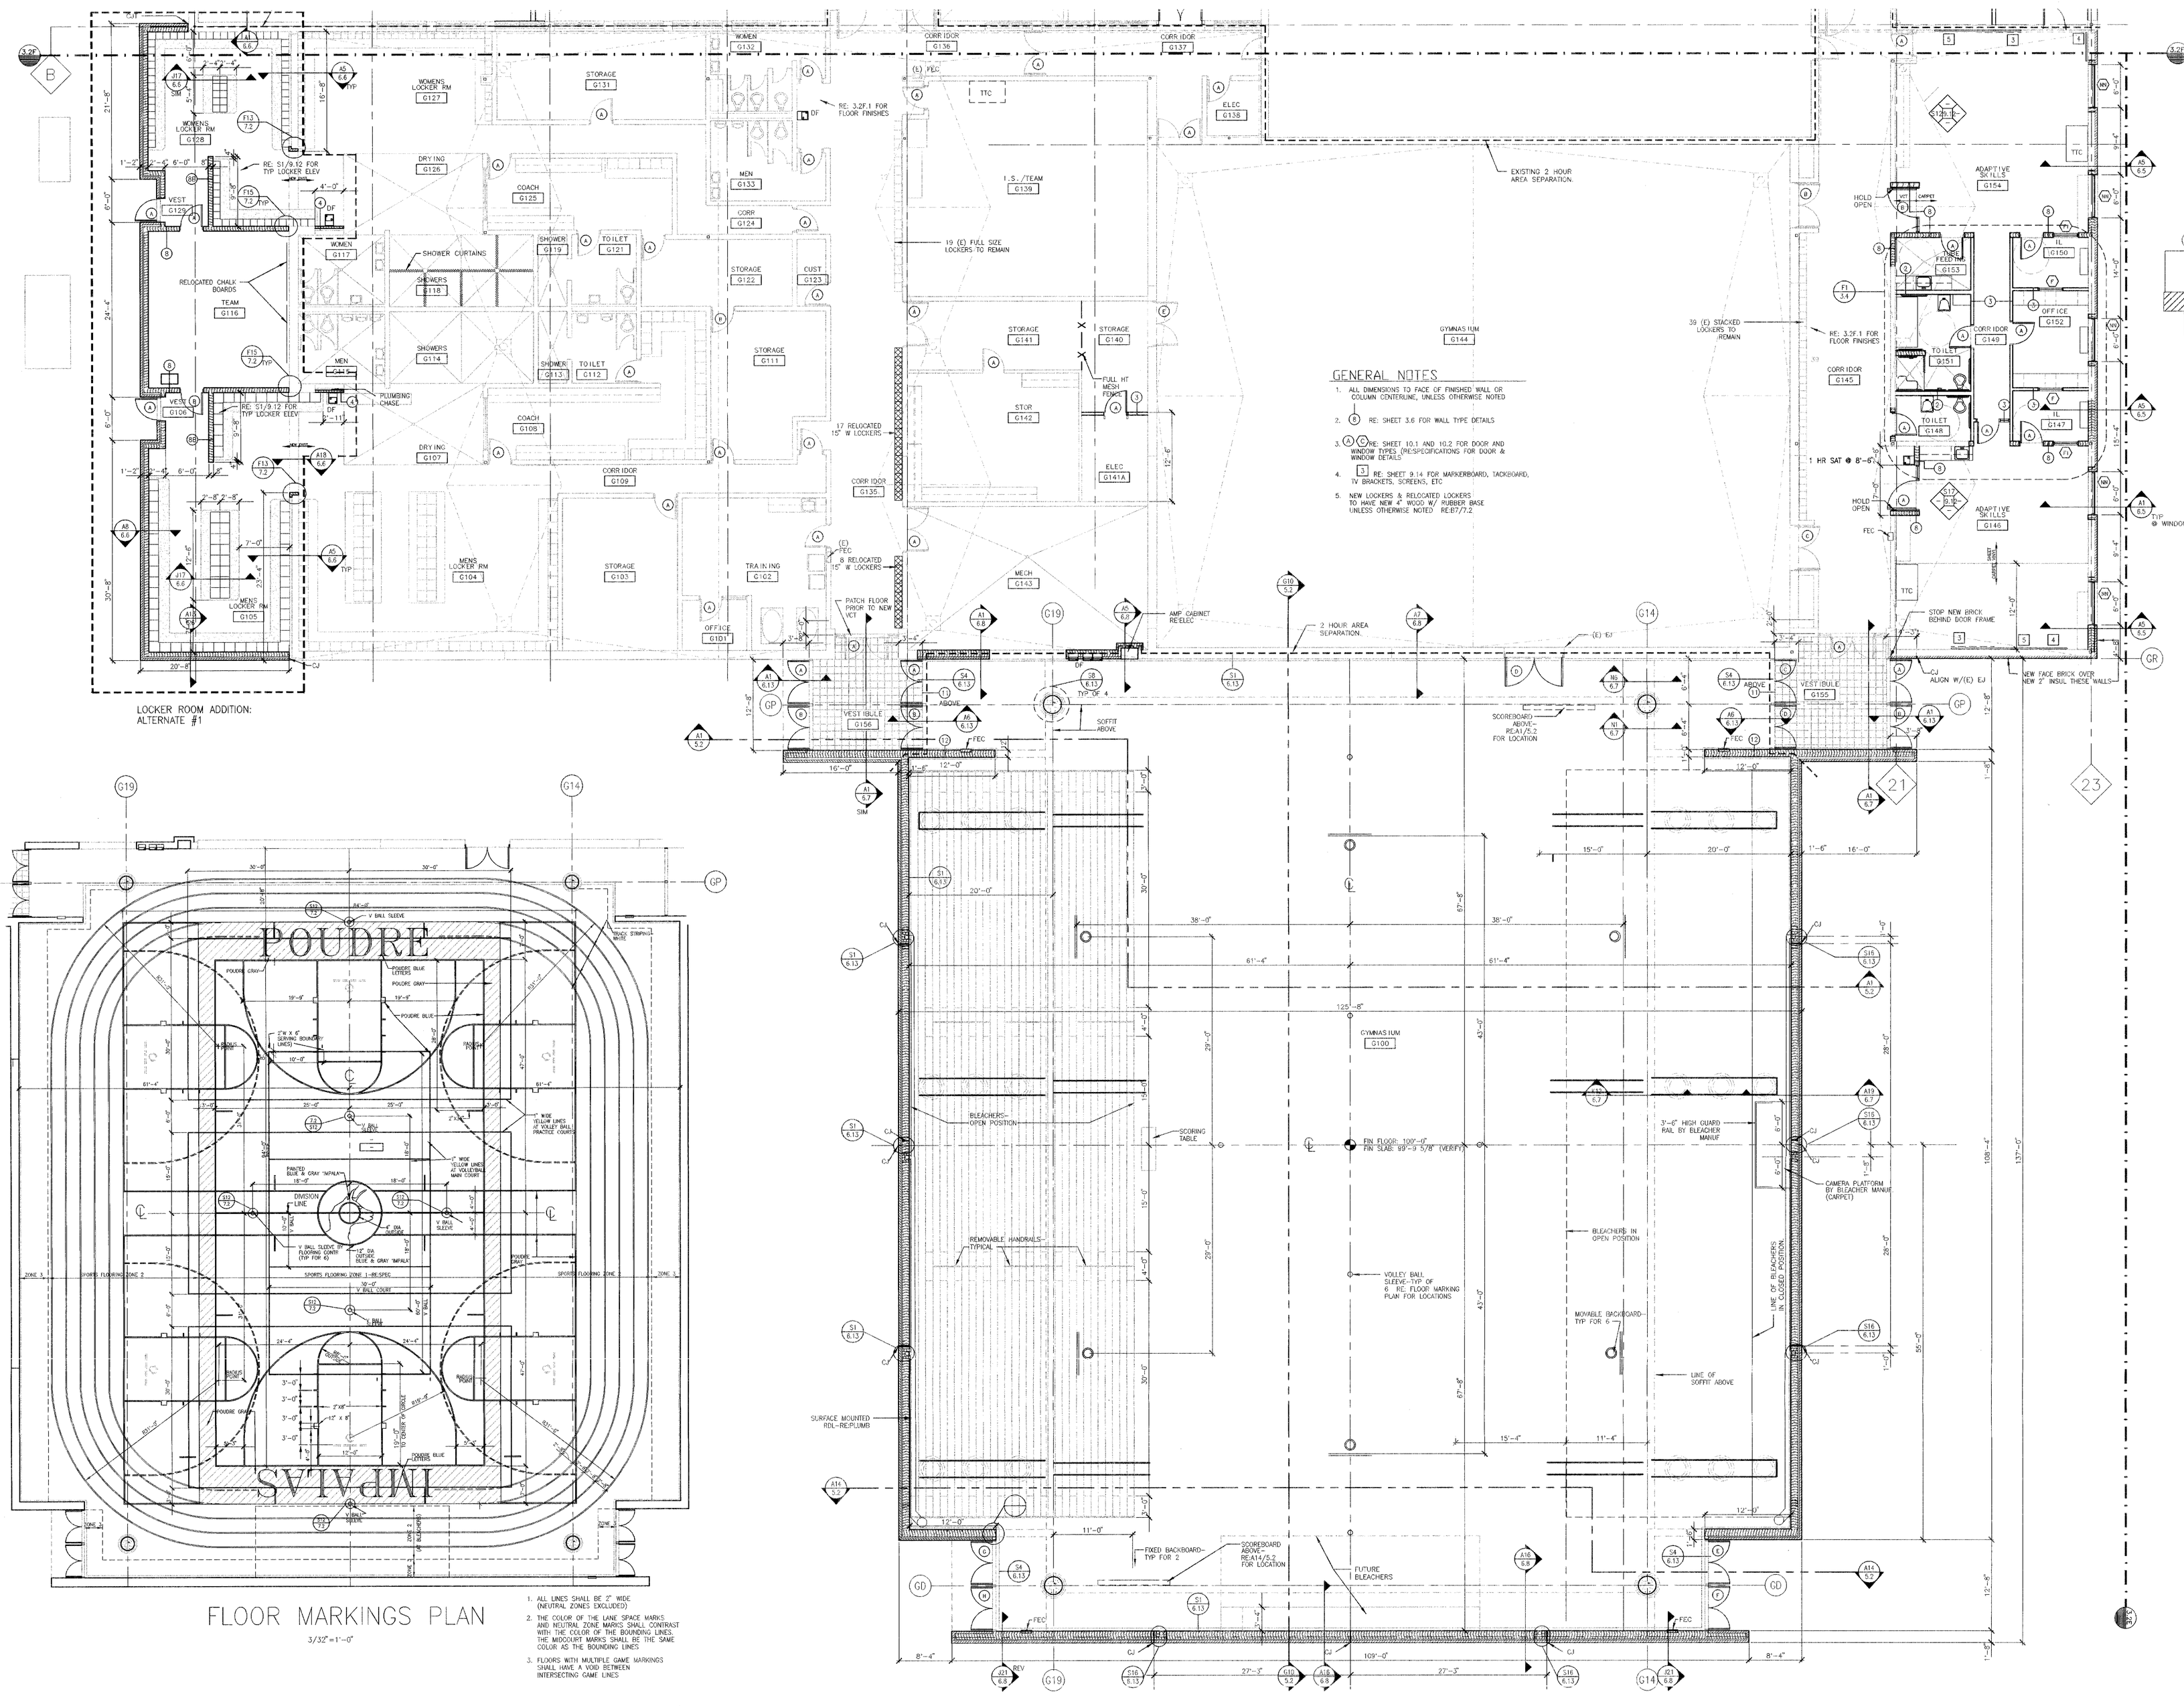

FLOOR MARKINGS PLAN

3/32" = 1'-0"

1. ALL LINES SHALL BE 2" WIDE (NEUTRAL ZONES EXCLUDED)
2. THE COLOR OF THE LANE SPACE MARKS AND NEUTRAL ZONE MARKS SHALL CONTRAST WITH THE COLOR OF THE BOUNDING LINES. THE MIDCOURT MARKS SHALL BE THE SAME COLOR AS THE BOUNDING LINES
3. FLOORS WITH MULTIPLE GAME MARKINGS SHALL HAVE A VOID BETWEEN INTERSECTING GAME LINES

THIS RECORD DRAWING HAS BEEN PREPARED, IN PART, BASED UPON INFORMATION FURNISHED BY OTHERS. WHILE THIS INFORMATION IS BELIEVED TO BE RELIABLE, THE DESIGN PROFESSIONAL CANNOT ASSUME ITS ACCURACY, AND THUS IS NOT RESPONSIBLE FOR THE ACCURACY OF THIS RECORD DRAWING OR FOR ANY ERRORS OR OMISSIONS WHICH MAY HAVE BEEN INCORPORATED INTO IT AS A RESULT. THOSE RELYING ON THIS RECORD DOCUMENT ARE ADVISED TO OBTAIN INDEPENDENT VERIFICATION OF ITS ACCURACY BEFORE APPLYING IT FOR ANY PURPOSE.

POUDRE SCHOOL DISTRICT R-1

POUDRE HIGH SCHOOL

ADDITION AND REMODEL

FORT COLLINS, COLORADO

Robb, Brenner, and Bretig, Inc.
125 S. Howes – Suite 880
Fort Collins, CO 80521

RBB

JOB NUMBER 9222

DRAWN DP

CHECKED GAB

ISSUE 3/29/94

REVISIONS

RECORD DRAWING 10/4/95

SHEET NAME
FLOOR PLAN-AREA G
1/8"

SHEET NUMBER

3.2G

RECORD DRAWING

C:\PSC_JETT'S\9222\PHS\9269 Thu Jun 20 12:33:56 1996